
SUITE: 1200

RSF: 8,659

AS-BUILT CONFIGURATION

OFFICES	13
RECEPTION	1
CONFERENCE ROOMS	2
KITCHEN	1
OPEN WORK AREA	+/- 28

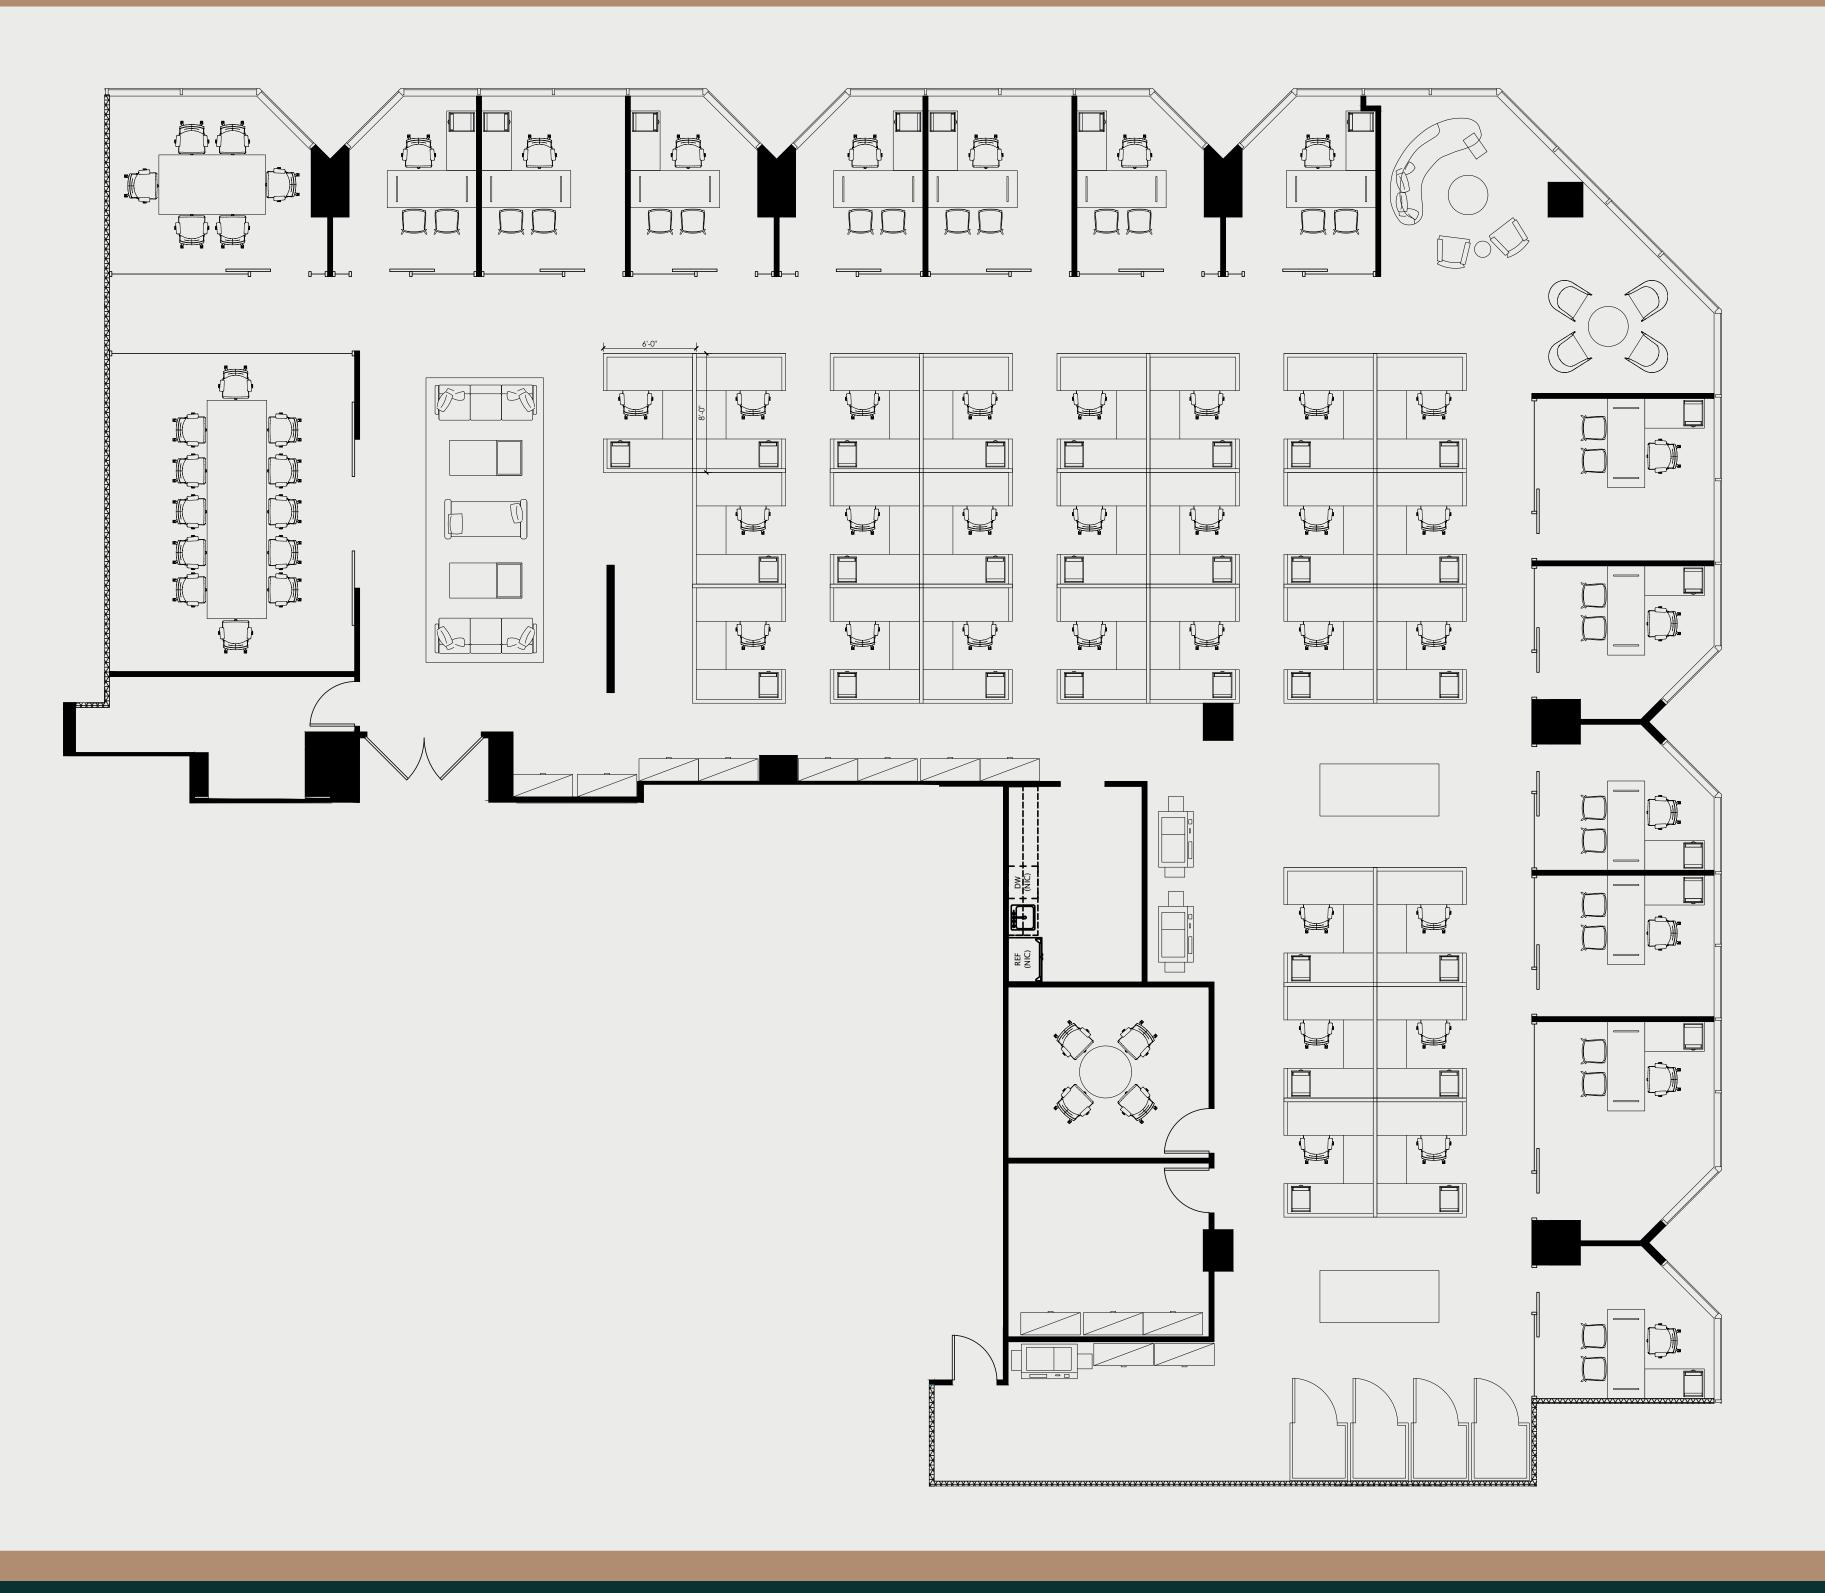

KEY PLAN: *Not to scale, furniture and appliances not included*

