


SUITE: 750

RSF: 8,548

AS-BUILT CONFIGURATION

- OFFICES.....11
- RECEPTION.....1
- CONFERENCE ROOMS.....1
- KITCHEN.....1
- OPEN WORK AREA.....+/-29

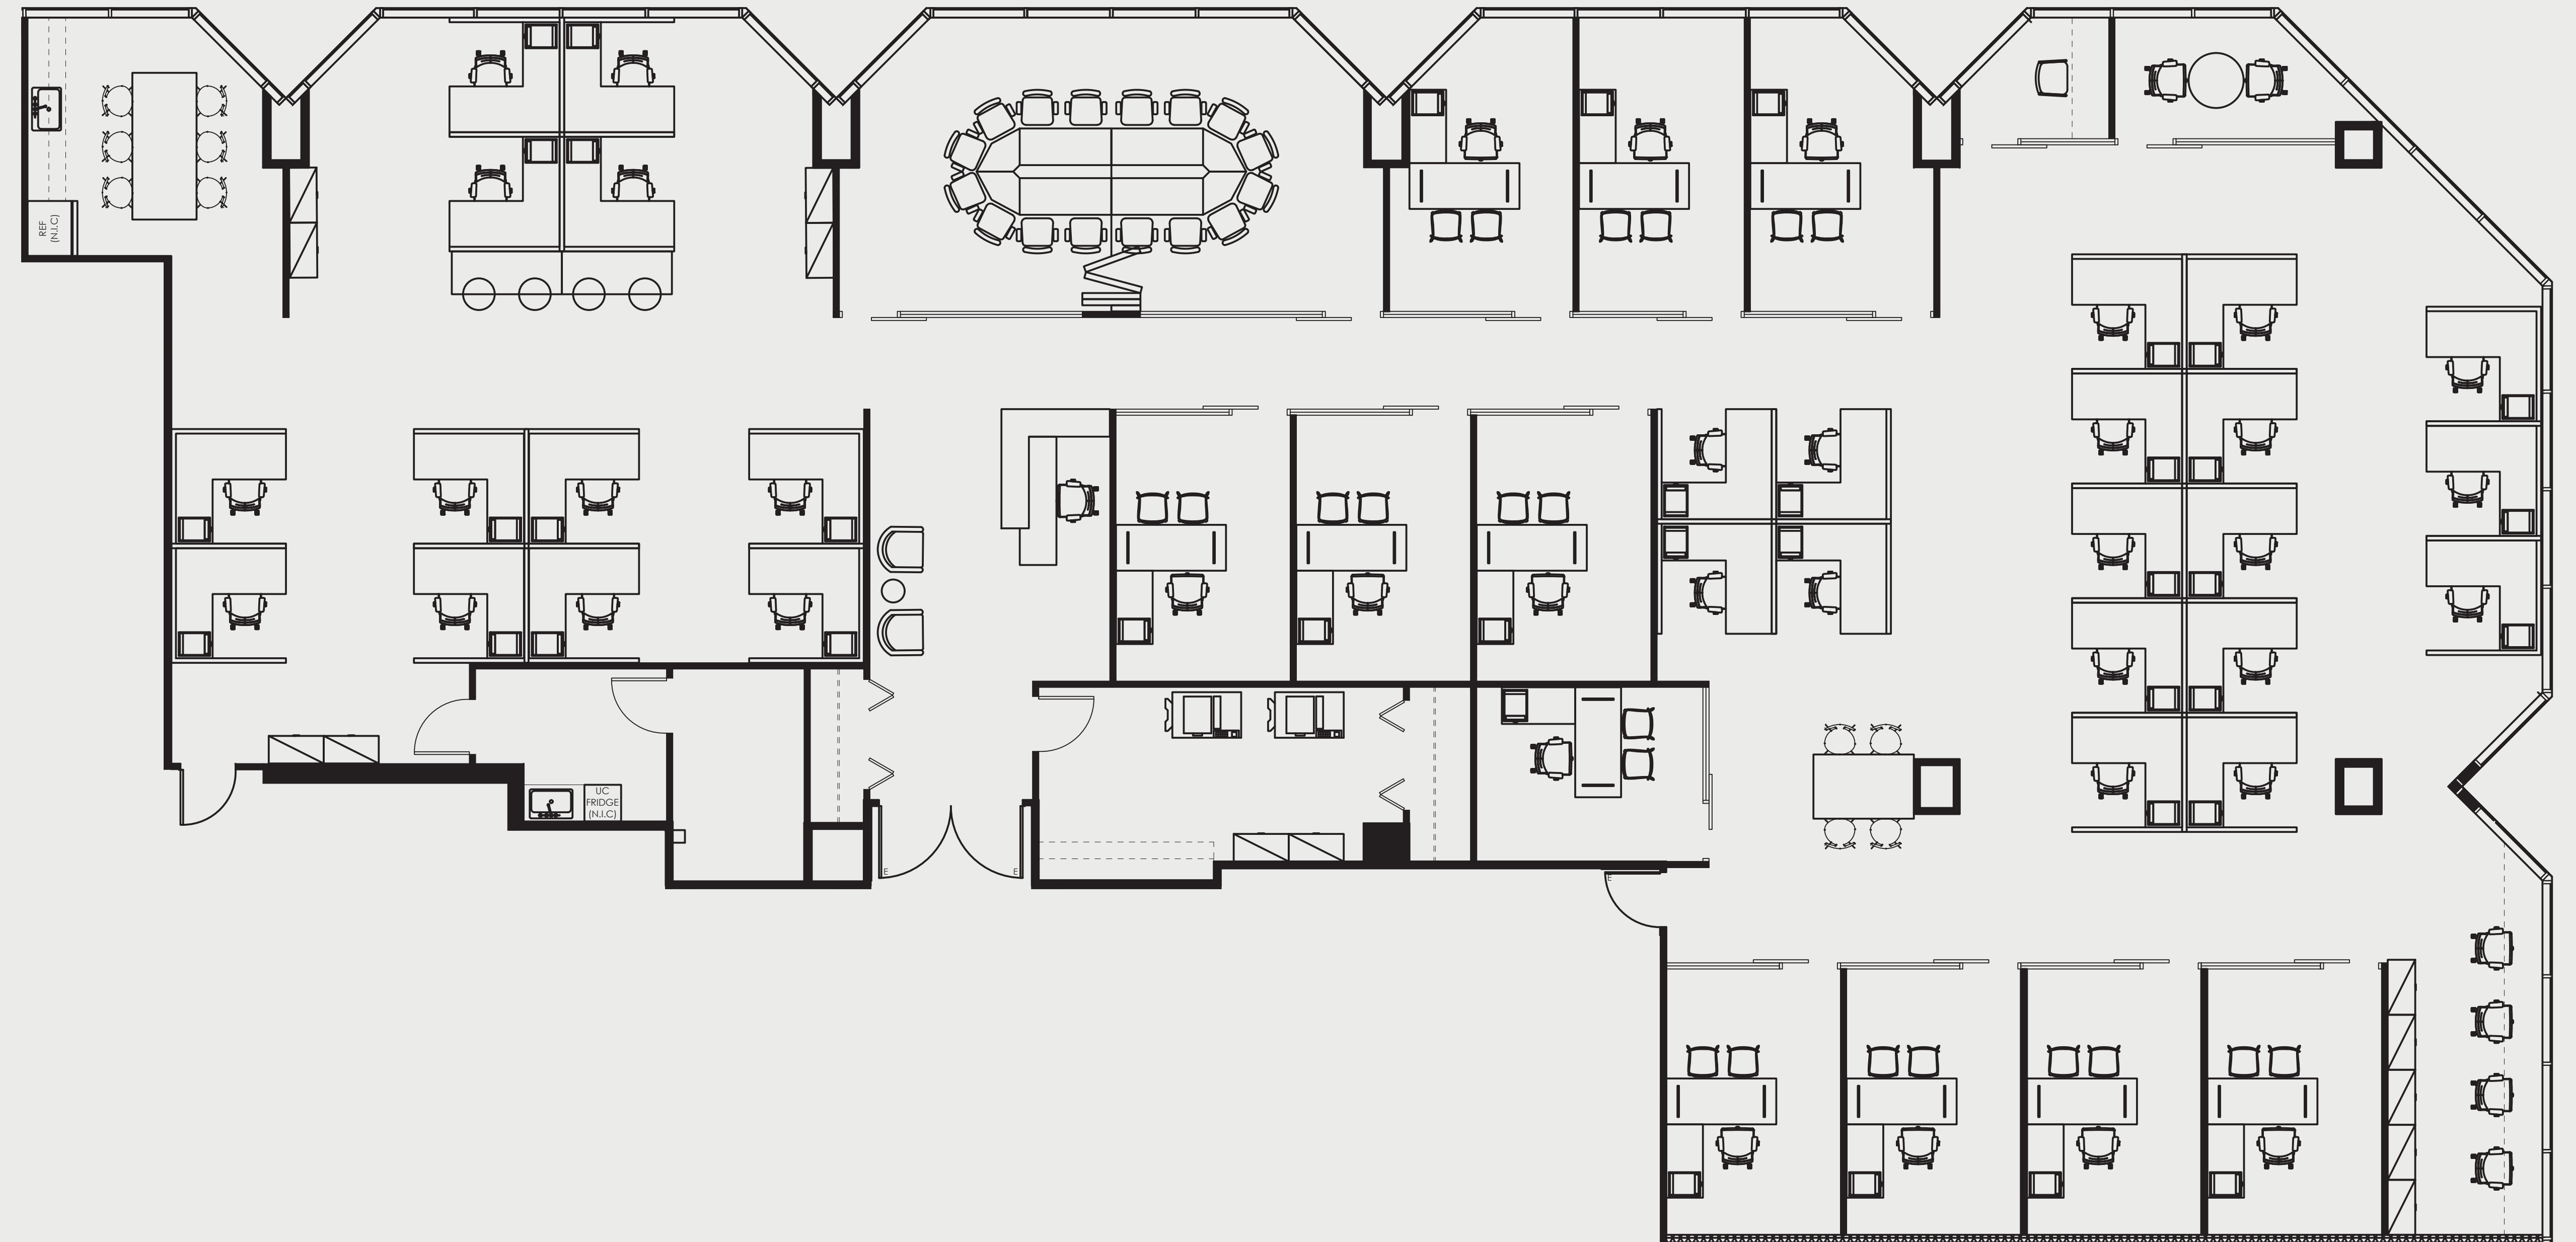

KEY PLAN:

Not to scale, furniture and appliances not included

